

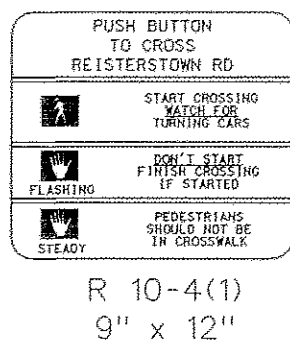
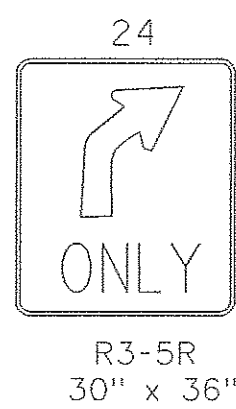
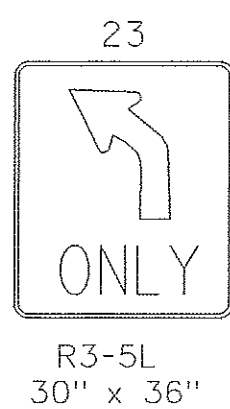


MD 140 IS ASSUMED TO RUN
IN A NORTH-SOUTH DIRECTION

EXISTING SIGNS

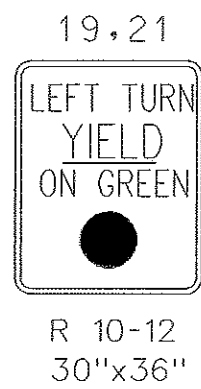


20, 22

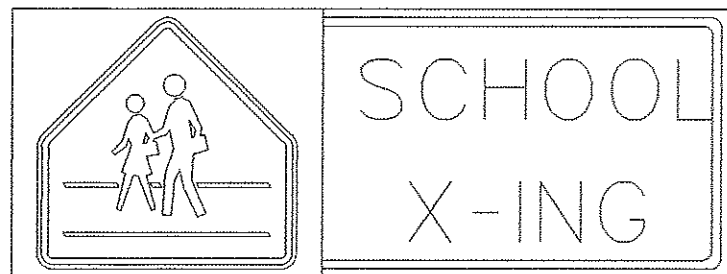


S2-1(2)

EXISTING SIGNALS

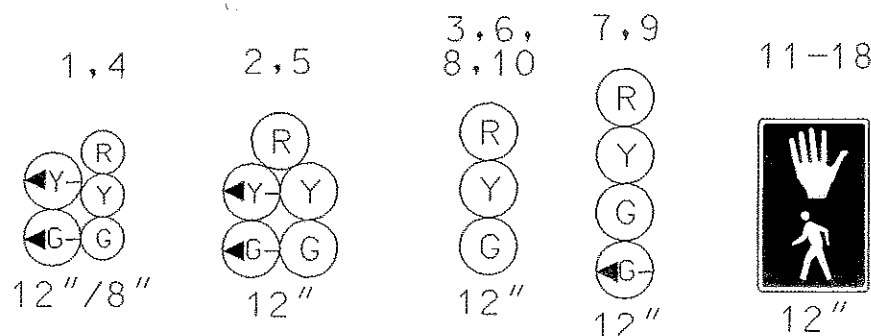

NEMA PHASING

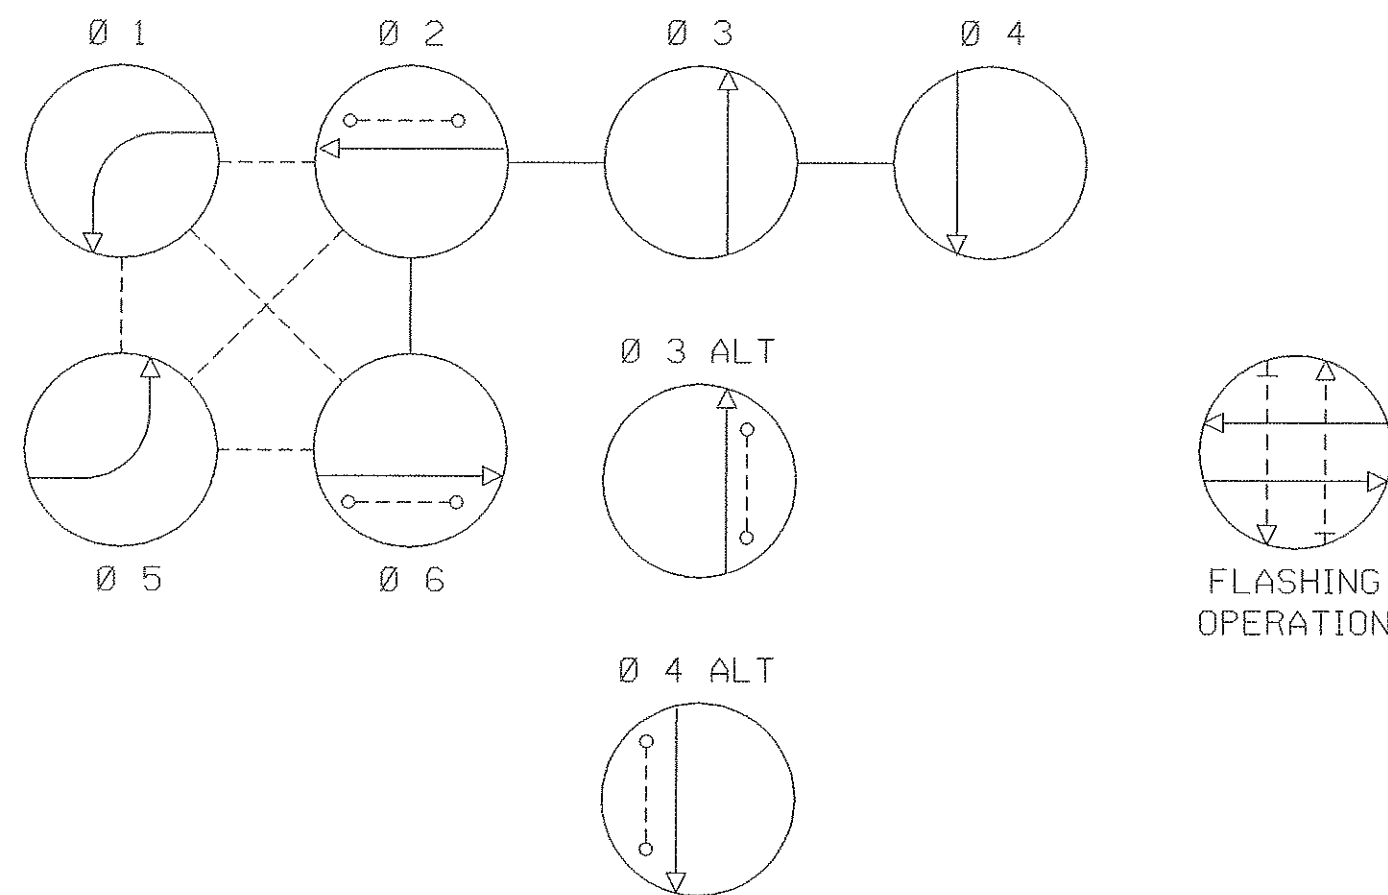

- PHASING NOTES
- PHASES ASSOCIATED BY A SOLID LINE WILL NOT OPERATE CONCURRENTLY.
 - PHASES ASSOCIATED BY A DASHED LINE WILL OPERATE CONCURRENTLY.

EQUIPMENT DETAILS


- 21' steel pole with a 50' mast arm, traffic signal heads and sign. (Note: 1-2", 90° polyvinyl chloride (Schedule 80) bend.)
- 21' steel pole with a 36' mast arm, traffic signal heads, signs, pedestrian signal head and pushbutton with pedestrian education sign. (Note: 1-2", 90° polyvinyl chloride (Schedule 80) bend.)
- 21' steel pole with a 38' mast arm, traffic signal heads, sign, pedestrian signal heads and pushbutton with pedestrian education sign. (Note: 1-2", 90° polyvinyl chloride (Schedule 80) bend.)
- 21' steel pole with a 38' mast arm, traffic signal heads and sign. (Note: 1-2", 90° polyvinyl chloride (Schedule 80) bend.)
- 10' breakaway pedestal pole, pedestrian signal heads, pushbutton with pedestrian education sign. (Note: 1-2", 90° polyvinyl chloride (Schedule 80) bend.)
- NEMA size "6" base-mounted cabinet and controller with all necessary equipment and meter socket and disconnect switch. (Note: 2-3", 90° polyvinyl chloride (Schedule 80) bends and 2-2", 90° polyvinyl chloride (Schedule 80) bends.)
- 6' x 30' loop detector encased in 1/4" flexible tubing quadrupole type (3-6-3).
- 6' x 6' loop detector encased in 1/4" flexible tubing (4-turns).
- Handhole.
- 2" polyvinyl chloride electrical conduit (Schedule 80).
- 3" polyvinyl chloride electrical conduit (Schedule 80).
- Underground power service by BG&E.

GENERAL NOTES:

- This plan reflects only those underground utilities that were apparent at the time of this location being asbuilt. A detailed review was not undertaken and this plan should not be construed as representing all underground utilities in the area.
- Any modification to this subject signal should be preceded by a thorough identification of all existing utilities.

UTILITY LEGEND

- G — GAS MAIN
- W — WATER MAIN
- S — SEWER MAIN
- E — ELECTRIC CABLES
- A — AERIAL CABLES
- T — TELEPHONE CABLES

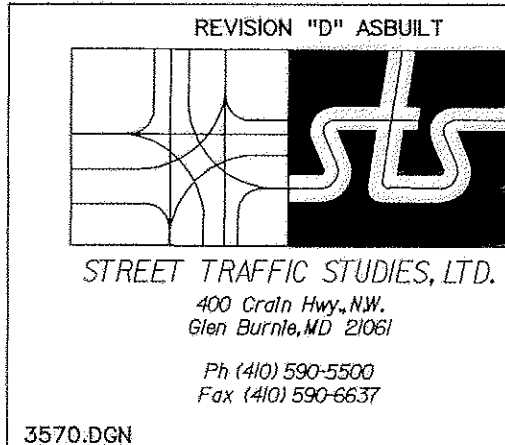

REVISIONS		APPROVALS	
①	ASBUILT	ASST. CHIEF TRAFFIC ENGINEERING DESIGN DIVISION	
RRZ	OCTOBER, 8 1998	ASST. DISTRICT ENGINEER, TRAFFIC	
C	SIGNAL MODIFICATION FOR NEW ACCESS TO FRANKLIN HIGH SCHOOL	CHIEF TRAFFIC ENGINEERING DESIGN DIVISION	
B	REBUILD AND INSTALL INTERCONNECT. S.H.A. No.: B-158-501-485	DIRECTOR, TRAFFIC & SAFETY	



MARYLAND DOT - STATE HIGHWAY ADMINISTRATION
Office of Traffic & Safety
TRAFFIC ENGINEERING DESIGN DIVISION

MD 140 @ FRANKLIN HIGH SCHOOL

DRAWN BY: J. Gordon	F.A.P. NO.	TS NO.	SHEET NO.
CHECKED BY: S. Renzi	S.H.A. NO.		
SCALE: 1" = 20'	COUNTY: BALTIMORE	T.I.M.S. NO. 943 D	1 OF 1
DATE: JUNE 11, 1973	LOG MILE: 030114008.17		